


© 2020 TE Connectivity. All Rights Reserved.

REVISIONS

P	LTR	DESCRIPTION	DATE	DWN	APVD
	A1	REVISED ECR-20-006447	09JUL2020	VI	SPB

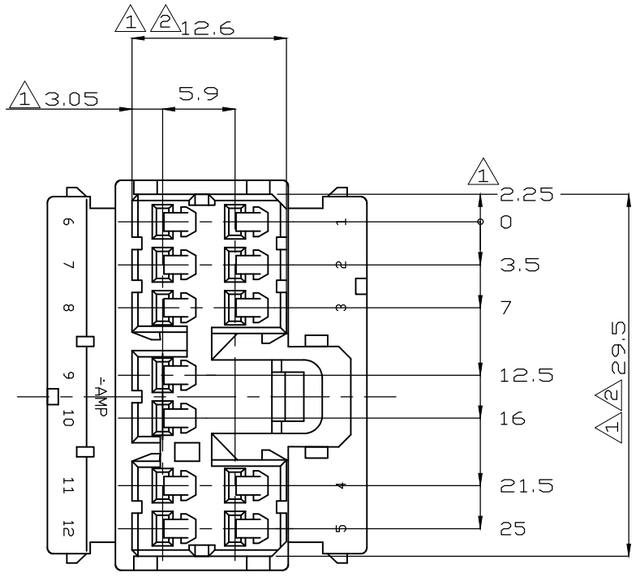

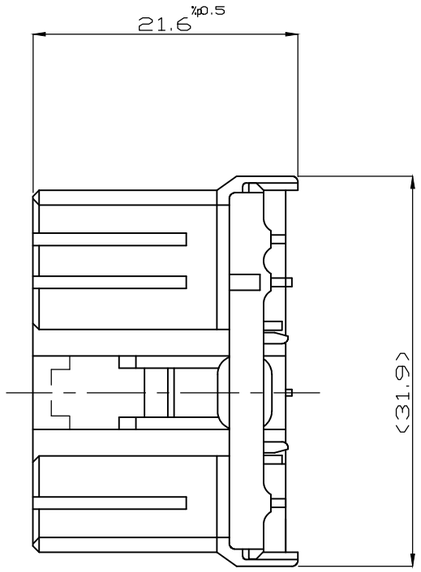

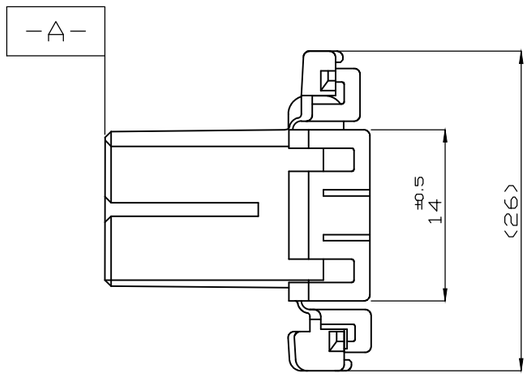

NOTES

1. MUST BE KEPT BETWEEN -A- AND 2.
2. TO BE MATE WITH CAP HSG SMOOTHLY.
3. APPLIED CONTACT P/N: 173630, 173631.

OBSOLETE (A)

P/N	COLOR
~~368542-9~~	~~BLACK~~
368542-1	NATURAL

THIS DRAWING IS A CONTROLLED DOCUMENT.

DIMENSIONS: mm

TOLERANCES UNLESS OTHERWISE SPECIFIED:

0 PLC	± –
1 PLC	± –
2 PLC	± –
3 PLC	± –
4 PLC	± –
ANGLES	± –

MATERIAL: P.B.T

FINISH: –

TOLERANCES UNLESS OTHERWISE SPECIFIED:

0 <XX<10	± 0.2
10<XX<30	± 0.25
30<XX	± 0.3
ANGLES	± 3°

DWN	–
CHK	–
APVD	–
PRODUCT SPEC	–
APPLICATION SPEC	–
WEIGHT	0

CUSTOMER DRAWING

TE Connectivity Ltd.

NAME: .070 MLC 12P PLUG HSG. – –

SIZE	CAGE CODE	DRAWING NO	RESTRICTED TO
A3	00779	C-368542	–

SCALE	SHEET	REV
1:1	1 OF 1	A1

Unikeyic Electronics

Global Electronic Components Distributor

Click to view pricing, inventory, delivery, and lifecycle information:

TE Connectivity:

1-794222-0 1969656-1 2377783-2 3-1393225-0 SBCHE154R7K 1-962915-1 2-292161-3 2005330-1
141991-2 175977-2 2834055-1 650075-000 ROX05SJ18R SBCHE64R7K SMW73R0JT 3430B2F51RTDF
936348-1 CPF0402B37K4E1 CRGCQ2010J3K3 1743455-2 2380312-2 1393431-1 MPT100C18RF
RH73H2A40MKTN 2310537-1 1903112-2 3631B101LL 917696-1 TE50BR39J U5254-000005-030PA