

© 2020 TE Connectivity. All Rights Reserved.


REVISIONS					
P	LTR	DESCRIPTION	DATE	DWN	APVD
	A	INITIAL RELEASE	06NOV2020	GTG	TD
	A1	ECN-21-103116	29APR2021	PK	YS
	A2	ECN-22-169734	05AUG2022	SM	PK
	A3	REV PER ECN-24-270255	20JUN2024	SMR	LM


1. DELIVER WITH LEVER AND CPA CLOSED POSITION
2. LASER MARK DATE CODE: YYDDD HH:MM FORMAT
3. LASER MARK TE PART NUMBER
4. FOR MATING COMPONENTS SEE C-2349157
5. LASER MARK "OK"
6. CAVITY ID MARKING IN RECESSED AREA

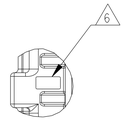



DETAIL A
SCALE 2:1

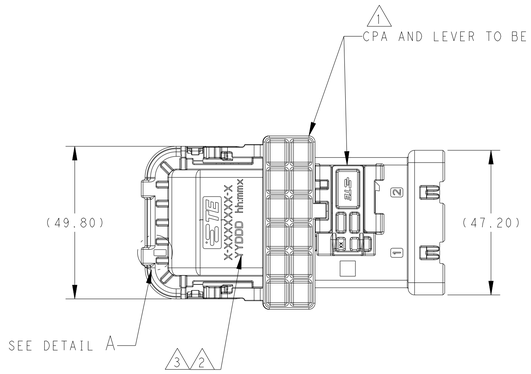

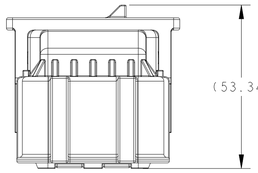


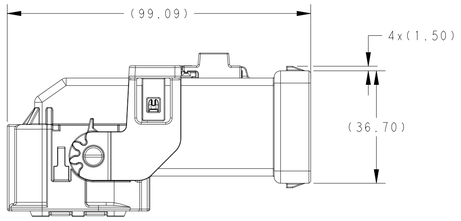

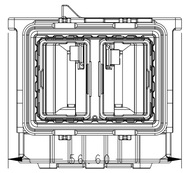


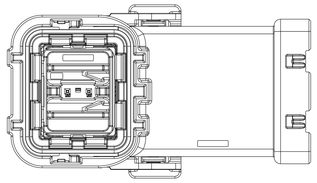


2840900-1 SHOWN
UNLESS OTHERWISE SPECIFIED

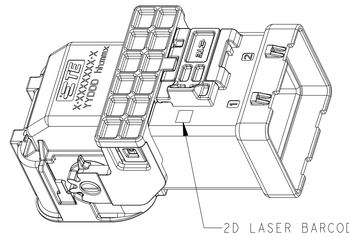


2840900-1 SHOWN AS SHIPPED TO TIER ONE CUSTOMER
FROM TE (LEVER AND CPA CLOSED)

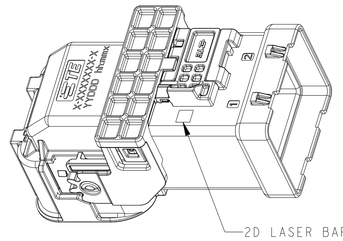

1-2840900-1 SHOWN AS SHIPPED TO TIER ONE CUSTOMER
FROM TE (LEVER AND CPA CLOSED)

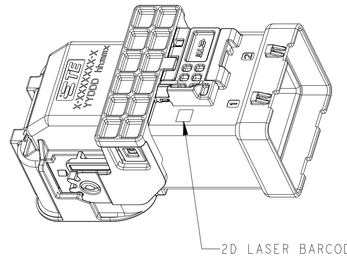


2-2840900-1 SHOWN AS SHIPPED TO TIER ONE CUSTOMER
FROM TE (LEVER AND CPA CLOSED)

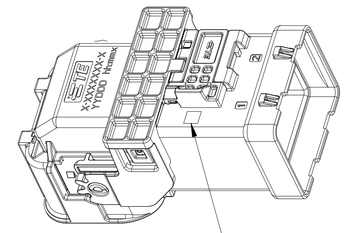


3-2840900-1 SHOWN AS SHIPPED TO TIER ONE CUSTOMER
FROM TE (LEVER AND CPA CLOSED)

5	ACTIVE	HC-STAK 25 PLUG ASSEMBLY KEY B	B	3-2840900-2
5		HC-STAK 25 PLUG ASSEMBLY KEY A	A	3-2840900-1
5		HC-STAK 25 PLUG ASSEMBLY KEY B	B	2-2840900-2
5		HC-STAK 25 PLUG ASSEMBLY KEY A	A	2-2840900-1
5	SUPERSEDED	~~HC-STAK 25 PLUG ASSEMBLY KEY B~~	B	~~1-2840900-2~~
5		~~HC-STAK 25 PLUG ASSEMBLY KEY A~~	A	~~1-2840900-1~~
5		~~HC-STAK 25 PLUG ASSEMBLY KEY B~~	B	2840900-2
5		~~HC-STAK 25 PLUG ASSEMBLY KEY A~~	A	2840900-1
	STATUS	DESCRIPTION	INDEX	PART NUMBER

KEY A
X-2840900-1

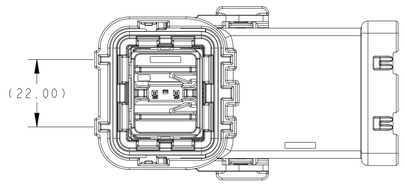

KEY B
X-2840900-2

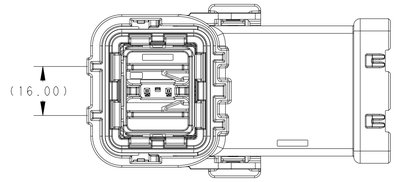

THIS DRAWING IS A CONTROLLED DOCUMENT.

DIMENSIONS: mm

TOLERANCES UNLESS OTHERWISE SPECIFIED
0 PLC ±
1 PLC ±
2 PLC ±
3 PLC ±
4 PLC ±
ANGLES ±

MATERIAL -
FINISH -

DWN P KOLHATKAR 03SEP2020
CHK T DEWITTE 03SEP2020
APVD T DEWITTE 03SEP2020
PRODUCT SPEC 108-160108
APPLICATION SPEC 114-162001
WEIGHT -

TE Connectivity

NAME PLUG SUB-ASSEMBLY
HC-STAK 25-2PH1
-

SIZE	CAGE CODE	DRAWING NO	RESTRICTED TO
A1	00779	C-2840900	

CUSTOMER DRAWING | SCALE 1:1 | SHEET 1 OF 1 | REV A3

4805 (3/13)

Unikeyic Electronics

Global Electronic Components Distributor

Click to view pricing, inventory, delivery, and lifecycle information:

TE Connectivity:

1969656-1 2310537-1 2834055-1 CRGCQ2010J3K3 RH73H2A40MKTN SMW73R0JT 1-962915-1
2005330-1 936348-1 TE50BR39J 1-794222-0 1393431-1 1903112-2 3631B101LL 1743455-2 175977-2
SBCHE64R7K U5254-000005-030PA 3-1393225-0 141991-2 2380312-2 3430B2F51RTDF 650075-000
917696-1 MPT100C18RF ROX05SJ18R 2-292161-3 2377783-2 CPF0402B37K4E1 SBCHE154R7K