THIS DRAWING IS UNPUBLISHED. RELEASED FOR PUBLICATION SEP ,2005.
© COPYRIGHT 2005 By – ALL RIGHTS RESERVED.

LOC J DIST –

REVISIONS

P	LTR	DESCRIPTION	DATE	DWN	APVD
	G	REVISED PER ECO-21-008223	21DEC2021	AK	SZ

NOTICE: THIS COMMUNICATION INCLUDES TE CONNECTIVITY CONFIDENTIAL OR PROPRIETARY INFORMATION THAT MAY ALSO BE LEGALLY PRIVILEGED.

TOOL STATUS	PART NUMBER MARKING (6)	CONTACT ALEA PLATING SPEC J (3)	DIM H	SCREW SIZE DIM G (5)	DIM F	DIM E	DIM D	DIM C	DIM B	DIM A	BOSS (4)	PACKING	CONNECTOR TYPE	PART NUMBER
AVAILABLE	WITHOUT P/N	Au 0.1um MIN OVER PdNi 0.2um MIN	6.28	–	0.5	10.05	–	–	2.2	1.8	WITHOUT BOSS	EMBOSS PACKING (SEE SHEET 2)	WITHOUT FLANGE TYPE (SEE SHEET 8)	1747981-3 (F7)
AVAILABLE	WITHOUT P/N	Au 0.76um	16.3	M3 x 0.5	0.5	10.05	10.95	7.98	2.2	1.8	WITHOUT BOSS	EMBOSS PACKING (SEE SHEET 3)	WITH FLANGE TYPE (SEE SHEET 7)	1-1747981-9
~~AVAILABLE~~	~~WITHOUT P/N~~	~~Au 0.1um MIN OVER PdNi 0.2um MIN~~	~~6.28~~	~~–~~	~~0.5~~	~~10.55~~			~~1.1~~	~~1.1~~	~~WITHOUT BOSS~~	EMBOSS PACKING (SEE SHEET 2)	WITHOUT FLANGE TYPE (SEE SHEET 6)	~~9-1747981-2~~ OB
~~AVAILABLE~~	~~WITH P/N~~	~~Au 0.1um MIN OVER PdNi 0.2um MIN~~	~~–~~	~~M3 x 0.5~~	~~1.0~~	~~10.55~~	~~12.75~~	~~10.08~~	~~2.2~~	~~1.8~~	~~WITH BOSS~~	SOFT TRAY PACKING (SEE SHEET 4)	WITH FLANGE TYPE (SEE SHEET 7)	~~9-1747981-1~~ OB
AVAILABLE	WITHOUT P/N	Au 0.1um MIN OVER PdNi 0.2um MIN	16.3	M3 x 0.5	0.5	10.05	10.95	7.98	2.2	1.8	WITHOUT BOSS	EMBOSS PACKING (SEE SHEET 3)	WITH FLANGE TYPE (SEE SHEET 7)	8-1747981-2 2-1747981-5
~~AVAILABLE~~	~~WITHOUT P/N~~	~~Au 0.1um MIN OVER PdNi 0.2um MIN~~	~~–~~	~~M3 x 0.5~~	~~0.5~~	~~10.05~~	~~10.95~~	~~7.98~~	~~2.2~~	~~1.8~~	~~WITHOUT BOSS~~	CLEAR TRAY PACKING (SEE SHEET 4)	WITH FLANGE TYPE (SEE SHEET 7)	~~8-1747981-1~~ OB
~~AVAILABLE~~	~~WITHOUT P/N~~	~~Au 0.1um MIN OVER PdNi 0.2um MIN~~	~~–~~	~~M3 x 0.5~~	~~1.0~~	~~10.55~~	~~12.75~~	~~10.08~~	~~2.2~~	~~1.8~~	~~WITH BOSS~~	SOFT TRAY PACKING (SEE SHEET 4)	WITH FLANGE TYPE (SEE SHEET 7)	~~3-1747981-1~~ OB
~~NOT AVAILABLE~~	~~WITHOUT P/N~~	~~Au 0.1um MIN OVER PdNi 0.2um MIN~~	~~16.3~~	~~#4-40 UNC~~	~~0.5~~	~~10.55~~	~~12.75~~	~~10.08~~	~~2.2~~	~~1.8~~	~~WITH BOSS~~	EMBOSS PACKING (SEE SHEET 3)	WITH FLANGE TYPE (SEE SHEET 7)	~~2-1747981-4~~ OB
AVAILABLE	WITHOUT P/N	Au 0.76um MIN	16.3	M3 x 0.5	1.0	10.55	12.75	10.08	2.2	1.8	WITHOUT BOSS	EMBOSS PACKING (SEE SHEET 3)	WITH FLANGE TYPE (SEE SHEET 7)	2-1747981-3
NOT AVAILABLE	WITHOUT P/N	Au 0.1um MIN OVER PdNi 0.2um MIN	–	#4-40 UNC	0.5	10.05	12.75	10.08	2.2	1.8	WITHOUT BOSS	HARDTRAY PACKING (–)	WITH FLANGE TYPE (SEE SHEET 7)	2-1747981-2
AVAILABLE	WITHOUT P/N	Au 0.76um MIN	–	M3 x 0.5	1.0	10.55	12.75	10.08	2.2	1.8	WITHOUT BOSS	SOFT TRAY PACKING (SEE SHEET 4)	WITH FLANGE TYPE (SEE SHEET 7)	2-1747981-1
~~AVAILABLE~~	~~WITHOUT P/N~~	~~Au 0.1um MIN OVER PdNi 0.2um MIN~~	~~–~~	~~M3 x 0.5~~	~~1.0~~	~~10.55~~	~~12.75~~	~~10.08~~	~~1.5~~	~~1.5~~	~~WITHOUT BOSS~~	SOFT TRAY PACKING (SEE SHEET 4)	WITH FLANGE TYPE (SEE SHEET 7)	~~1-1747981-8~~ OB
~~AVAILABLE~~	~~WITHOUT P/N~~	~~Au 0.1um MIN OVER PdNi 0.2um MIN~~	~~16.3~~	~~M3 x 0.5~~	~~1.0~~	~~10.55~~	~~12.75~~	~~10.08~~	~~2.2~~	~~1.8~~	~~WITHOUT BOSS~~	EMBOSS PACKING (SEE SHEET 3)	WITH FLANGE TYPE (SEE SHEET 7)	~~1-1747981-7~~ OB
AVAILABLE	WITHOUT P/N	Au 0.1um MIN OVER PdNi 0.2um MIN	–	M3 x 0.5	0.5	10.05	10.95	7.98	2.2	1.8	WITHOUT BOSS	SOFT TRAY PACKING (SEE SHEET 5)	WITH FLANGE TYPE (SEE SHEET 7)	1-1747981-6
AVAILABLE	WITHOUT P/N	Au 0.1um MIN OVER PdNi 0.2um MIN	16.3	M3 x 0.5	0.5	10.05	10.95	7.98	1.5	1.5	WITHOUT BOSS	EMBOSS PACKING (SEE SHEET 3)	WITH FLANGE TYPE (SEE SHEET 7)	1-1747981-5
AVAILABLE	WITHOUT P/N	Au 0.1um MIN OVER PdNi 0.2um MIN	–	M3 x 0.5	1.0	10.55	12.75	10.08	2.2	1.8	WITHOUT BOSS	SOFT TRAY PACKING (SEE SHEET 4)	WITH FLANGE TYPE (SEE SHEET 7)	1-1747981-4
~~AVAILABLE~~	~~WITHOUT P/N~~	~~Au 0.1um MIN OVER PdNi 0.2um MIN~~	~~–~~	~~#4-40 UNC~~	~~0.5~~	~~10.05~~	~~12.75~~	~~10.08~~	~~2.2~~	~~1.8~~	~~WITHOUT BOSS~~	SOFT TRAY PACKING (SEE SHEET 4)	WITH FLANGE TYPE (SEE SHEET 7)	~~1-1747981-3~~ OB
AVAILABLE	WITHOUT P/N	Au 0.1um MIN OVER PdNi 0.2um MIN	–	M3 x 0.5	0.5	10.05	10.95	7.98	1.5	1.5	WITHOUT BOSS	SOFT TRAY PACKING (SEE SHEET 4)	WITH FLANGE TYPE (SEE SHEET 7)	1-1747981-2
AVAILABLE	WITHOUT P/N	Au 0.1um MIN OVER PdNi 0.2um MIN	–	M3 x 0.5	0.5	10.05	10.95	7.98	2.2	1.8	WITHOUT BOSS	SOFT TRAY PACKING (SEE SHEET 4)	WITH FLANGE TYPE (SEE SHEET 7)	1-1747981-1
AVAILABLE	WITHOUT P/N	Au 0.1um MIN OVER PdNi 0.2um MIN	6.28	–	0.5	10.05	–	–	1.5	1.5	WITHOUT BOSS	EMBOSS PACKING (SEE SHEET 2)	WITHOUT FLANGE TYPE (SEE SHEET 6)	1747981-2
AVAILABLE	WITHOUT P/N	Au 0.1um MIN OVER PdNi 0.2um MIN	6.28	–	0.5	10.05	–	–	2.2	1.8	WITHOUT BOSS	EMBOSS PACKING (SEE SHEET 2)	WITHOUT FLANGE TYPE (SEE SHEET 6)	1747981-1
AVAILABLE	WITHOUT P/N	Au 0.76um MIN	6.28	–	0.5	10.05	–	–	2.2	1.8	WITHOUT BOSS	EMBOSS PACKING (SEE SHEET 2)	WITHOUT FLANGE TYPE (SEE SHEET 6)	3-1747981-2

1 CONTACT COPLANALITY IS 0.1 MAXIMUM.
(2) THIS DIMENSION MEANS CENTER OF THE POCKET.
(3) FINISH
CONTACT: CONTACT AREA J: SEE TABLE
2μm MIN Sn PLATING ON SOLDERING AREA
2μm MIN Ni UNDER PLATING ALL OVER
SHELL: 1μm MIN Sn PLATING ALL OVER
1μm MIN Ni UNDER PLATING ALL OVER

(4) REFER TO THE TABLE FOR BO
(5) SCREW SIZE
(6) PART NUMBER MAKING

SS.

THIS DRAWING IS A CONTROLLED DOCUMENT.

DIMENSIONS: mm
TOLERANCES UNLESS OTHERWISE SPECIFIED:
0 PLC ± 0.2
1 PLC ± 0.2
2 PLC ± 0.2
3 PLC ± 0.2
4 PLC ± 0.2
ANGLES ± –
MATERIAL
FINISH

DWN Y.HIRATA 15SEP2005
CHK T.KIMURA 15SEP2005
APVD K.IKEGAMI 15SEP2005
PRODUCT SPEC 108-78180-1
APPLICATION SPEC
WEIGHT
CUSTOMER DRAWING

TE Connectivity

NAME
HDMI 19 POS
RECEPTACLE ASSY SMT TYPE
–LEAD FREE–

SIZE	CAGE CODE	DRAWING NO	RESTRICTED TO
A3	00779	C-1747981	–

SCALE NTS SHEET 1 OF 9 REV G


THIS DRAWING IS UNPUBLISHED. RELEASED FOR PUBLICATION SEP ,2005.
© COPYRIGHT 2005 By – ALL RIGHTS RESERVED.

LOC	DIST
J	—

REVISIONS


P	LTR	DESCRIPTION	DATE	DWN	APVD
	–	SEE SHEET 1	–	—	—

NOTICE: THIS COMMUNICATION INCLUDES TE CONNECTIVITY CONFIDENTIAL OR PROPRIETARY INFORMATION THAT MAY ALSO BE LEGALLY PRIVILEGED.

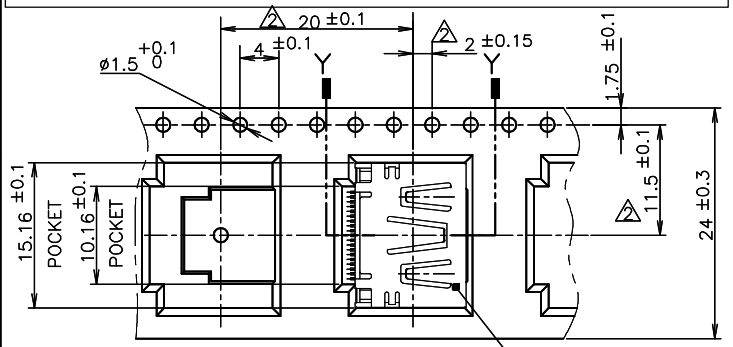



DETAIL X

CONNECTOR WITHOUT FLANGE TYPE

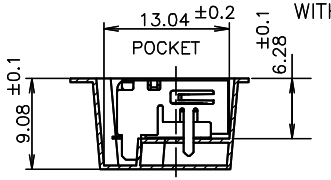


(F7)
SHOWN AS: 1747981-3

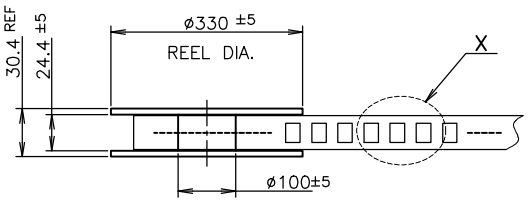

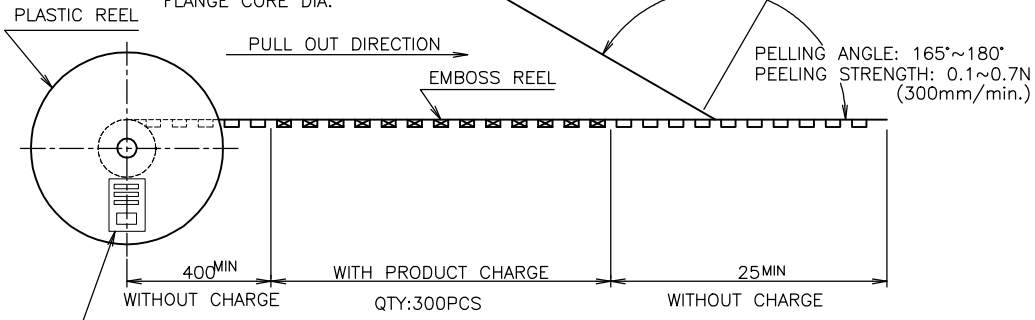


LABEL DESCRIPTION

TE CONNECTIVITY P/N.: 1747981-*
QTY: 300 pcs
D/C:
MADE IN CHINA

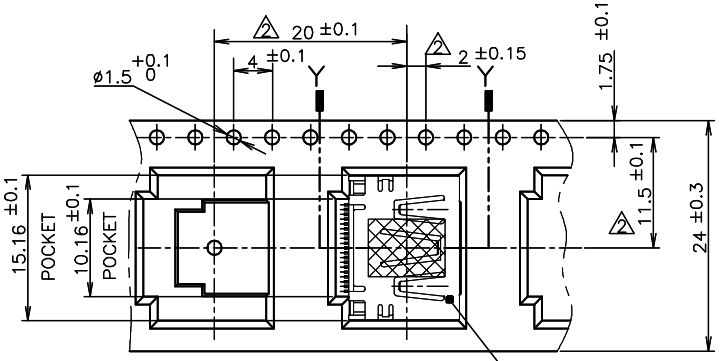

DETAIL X

CONNECTOR WITHOUT FLANGE TYPE

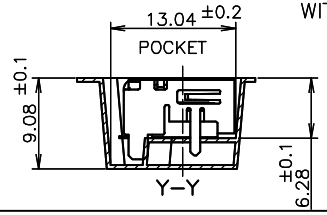

SHOWN AS:
3-1747981-2
9-1747981-2
1747981-2
1747981-1

QTY	MYLAR	CONNECTOR TYPE	PART NUMBER
300	WITHOUT	WITHOUT FLANGE TYPE	1747981-3
300	WITH	WITHOUT FLANGE TYPE	3-1747981-2
~~300~~	~~WITH~~	~~WITHOUT FLANGE TYPE~~	~~9-1747981-2~~
300	WITH	WITHOUT FLANGE TYPE	1747981-2
300	WITH	WITHOUT FLANGE TYPE	1747981-1

OB

THIS DRAWING IS A CONTROLLED DOCUMENT.

DIMENSIONS: mm
TOLERANCES UNLESS OTHERWISE SPECIFIED:
0 PLC ± 0.2
1 PLC ± 0.2
2 PLC ± 0.2
3 PLC ± 0.2
4 PLC ± 0.2
ANGLES ± –
MATERIAL
FINISH

DWN
CHK
APVD
PRODUCT SPEC 108-78180-1
APPLICATION SPEC
WEIGHT

TE Connectivity

NAME
HDMI 19 POS
RECEPTACLE ASSY SMT TYPE
-LEAD FREE-

SIZE	CAGE CODE	DRAWING NO	RESTRICTED TO
A3	00779	C-1747981	–

CUSTOMER DRAWING | SCALE NTS | SHEET 2 OF 9 | REV G


THIS DRAWING IS UNPUBLISHED. RELEASED FOR PUBLICATION SEP ,2005.
© COPYRIGHT 2005 By – ALL RIGHTS RESERVED.


NOTICE: THIS COMMUNICATION INCLUDES TE CONNECTIVITY CONFIDENTIAL OR PROPRIETARY INFORMATION THAT MAY ALSO BE LEGALLY PRIVILEGED.

LOC J DIST –


REVISIONS

P	LTR	DESCRIPTION	DATE	DWN	APVD
	–	SEE SHEET 1	–	–	–

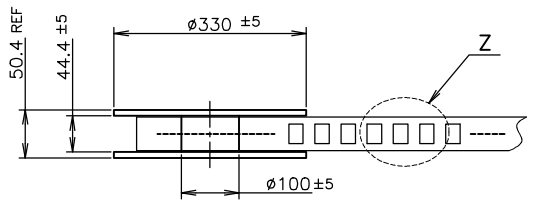


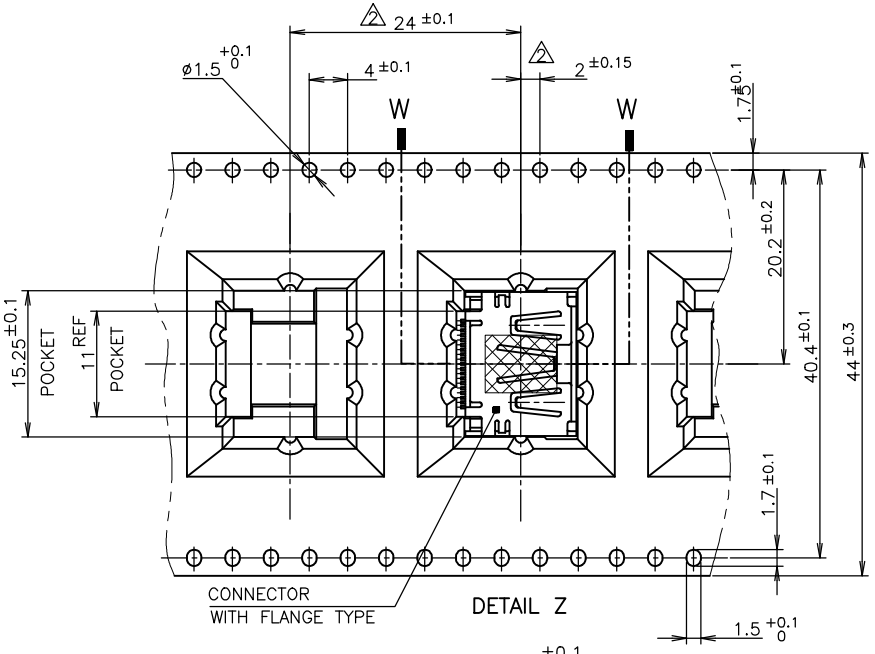

DETAIL Z

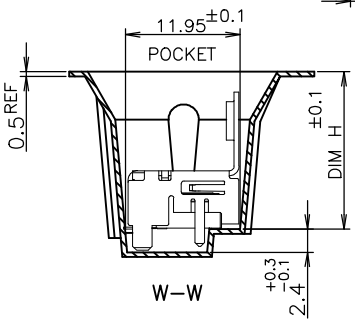

W–W

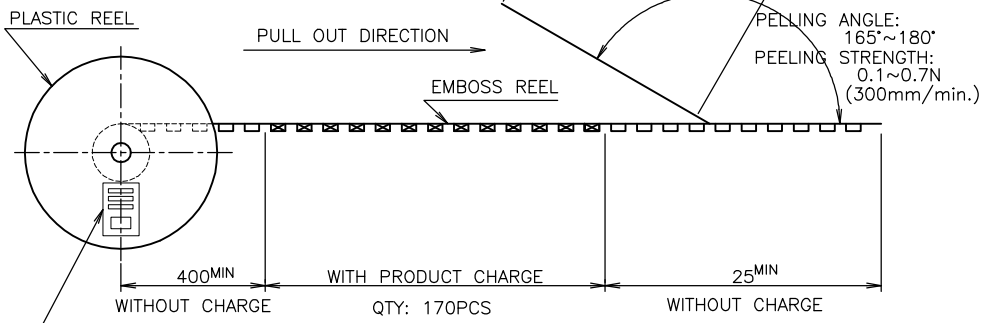

LABEL DESCRIPTION

TE CONNECTIVITY P/N.: *–1747981–*
QTY: 170 pcs
D/C:
MADE IN CHINA

	QTY	CONNECTOR TYPE	PART NUMBER
	170	WITH FLANGE TYPE	1–1747981–9
	170	WITH FLANGE TYPE	8–1747981–2
	170	WITH FLANGE TYPE	2–1747981–5
OB	~~170~~	~~WITH FLANGE TYPE~~	~~2–1747981–4~~
	170	WITH FLANGE TYPE	2–1747981–3
OB	~~170~~	~~WITH FLANGE TYPE~~	~~1–1747981–7~~
	170	WITH FLANGE TYPE	1–1747981–5

THIS DRAWING IS A CONTROLLED DOCUMENT.

DIMENSIONS: mm
TOLERANCES UNLESS OTHERWISE SPECIFIED:
0 PLC ± 0.2
1 PLC ± 0.2
2 PLC ± 0.2
3 PLC ± 0.2
4 PLC ± 0.2
ANGLES ±–
MATERIAL
FINISH

DWN
CHK
APVD
PRODUCT SPEC 108–78180–1
APPLICATION SPEC
WEIGHT

TE Connectivity

NAME
HDMI 19 POS
RECEPTACLE ASSY SMT TYPE
–LEAD FREE–

SIZE A3 | CAGE CODE 00779 | DRAWING NO C–1747981 | RESTRICTED TO –

CUSTOMER DRAWING | SCALE NTS | SHEET 3 OF 9 | REV


70 WITH FLANGE TYPE 1-1747981-9


THIS DRAWING IS UNPUBLISHED. RELEASED FOR PUBLICATION SEP ,2005.
© COPYRIGHT 2005 By – ALL RIGHTS RESERVED.


LOC	DIST
J	—

REVISIONS


P	LTR	DESCRIPTION	DATE	DWN	APVD
	–	SEE SHEET 1	–	–	–

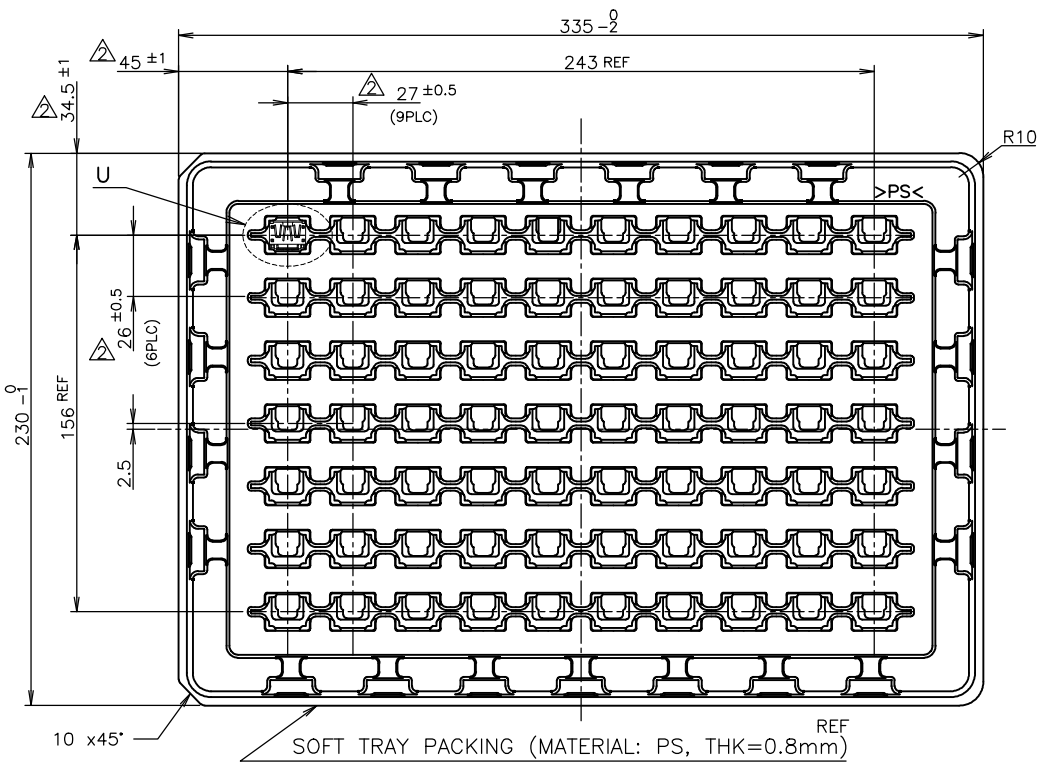

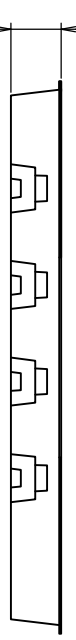

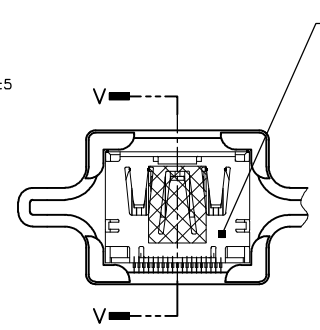

DETAIL U

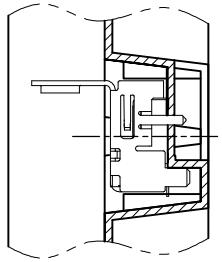

V–V

	QTY	CONNECTOR TYPE	PART NUMBER	
	70	WITH FLANGE TYPE	9–1747981–1	OB
	70	WITH FLANGE TYPE	8–1747981–1	OB
OB	70	WITH FLANGE TYPE	3–1747981–1	
	70	WITH FLANGE TYPE	2–1747981–1	
OB	70	WITH FLANGE TYPE	1–1747981–8	
	70	WITH FLANGE TYPE	1–1747981–4	
OB	70	WITH FLANGE TYPE	1–1747981–3	
	70	WITH FLANGE TYPE	1–1747981–2	
	70	WITH FLANGE TYPE	1–1747981–1	

NOTICE: THIS COMMUNICATION INCLUDES TE CONNECTIVITY CONFIDENTIAL OR PROPRIETARY INFORMATION THAT MAY ALSO BE LEGALLY PRIVILEGED.

THIS DRAWING IS A CONTROLLED DOCUMENT.

DIMENSIONS: mm

TOLERANCES UNLESS OTHERWISE SPECIFIED:

0 PLC	± 0.2	
1 PLC	± 0.2	
2 PLC	± 0.2	±0.3
3 PLC	± 0.2	
4 PLC	± 0.2	
ANGLES	± –	

MATERIAL

FINISH

DWN

CHK

APVD

PRODUCT SPEC 108–78180–1

APPLICATION SPEC

WEIGHT

TE Connectivity

NAME HDMI 19 POS
RECEPTACLE ASSY SMT TYPE
–LEAD FREE–

SIZE	CAGE CODE	DRAWING NO	RESTRICTED TO
A3	00779	C-1747981	–

CUSTOMER DRAWING

SCALE NTS

SHEET 4 OF 9


REV


THIS DRAWING IS UNPUBLISHED. RELEASED FOR PUBLICATION SEP ,2005.
© COPYRIGHT 2005 By – ALL RIGHTS RESERVED.


LOC	DIST
J	—

REVISIONS


P	LTR	DESCRIPTION	DATE	DWN	APVD
	–	SEE SHEET 1	–	—	—

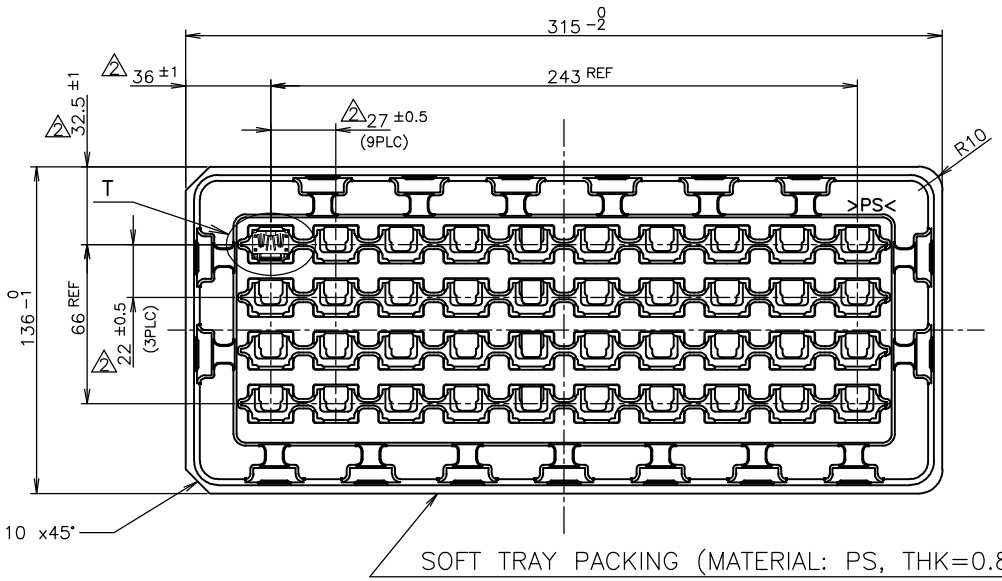

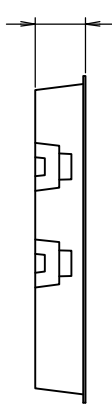

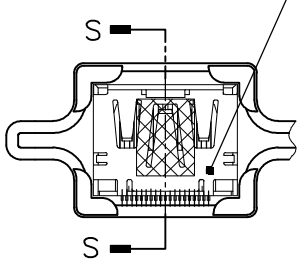

DETAIL T
(SCALE 2:1)

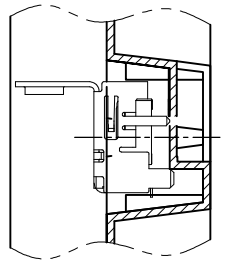

S–S
(SCALE 2:1)

NOTICE: THIS COMMUNICATION INCLUDES TE CONNECTIVITY CONFIDENTIAL OR PROPRIETARY INFORMATION THAT MAY ALSO BE LEGALLY PRIVILEGED.

THIS DRAWING IS A CONTROLLED DOCUMENT.

DIMENSIONS: mm

TOLERANCES UNLESS OTHERWISE SPECIFIED:

0 PLC	± 0.2	±0.3
1 PLC	± 0.2	
2 PLC	± 0.2	
3 PLC	± 0.2	
4 PLC	± 0.2	
ANGLES	± –	

MATERIAL

FINISH

QTY	CONNECTOR TYPE	PART NUMBER
40	WITH FLANGE TYPE	1–1747981–6

DWN

CHK

APVD

PRODUCT SPEC 108–78180–1

APPLICATION SPEC

WEIGHT

TE Connectivity

NAME HDMI 19 POS RECEPTACLE ASSY SMT TYPE –LEAD FREE–

SIZE	CAGE CODE	DRAWING NO	RESTRICTED TO
A3	00779	C–1747981	—

CUSTOMER DRAWING


SCALE	SHEET	REV
NTS	5 OF 9	

THIS DRAWING IS UNPUBLISHED. RELEASED FOR PUBLICATION SEP ,2005.
© COPYRIGHT 2005 By – ALL RIGHTS RESERVED.


LOC	DIST
J	—

REVISIONS


P	LTR	DESCRIPTION	DATE	DWN	APVD
	–	SEE SHEET 1	–	—	—

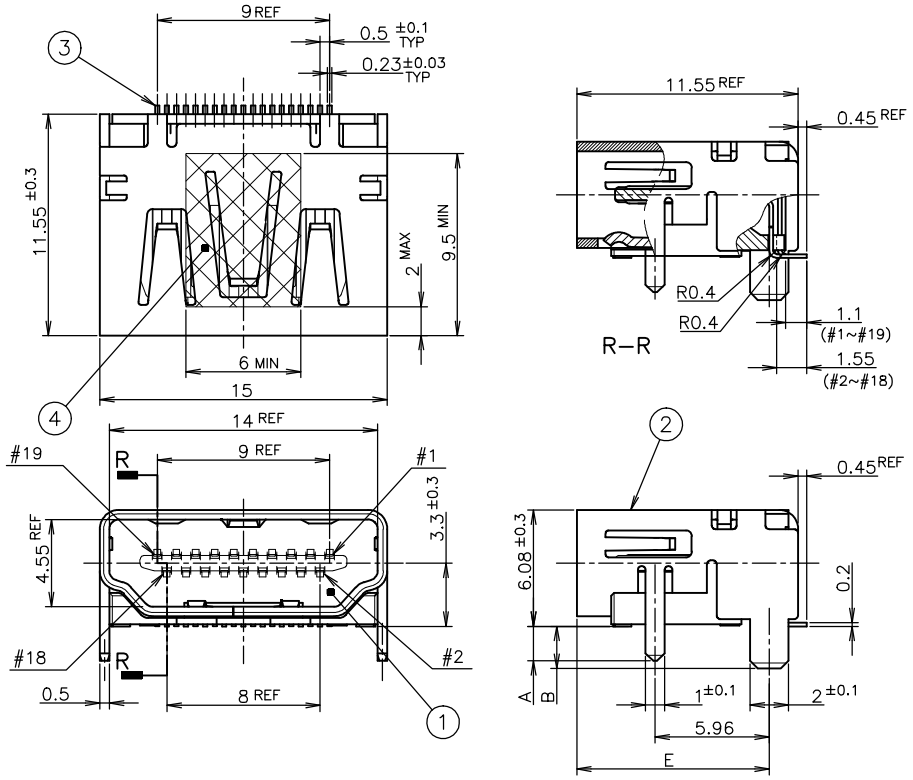

CONNECTOR WITHOUT FLANGE TYPE

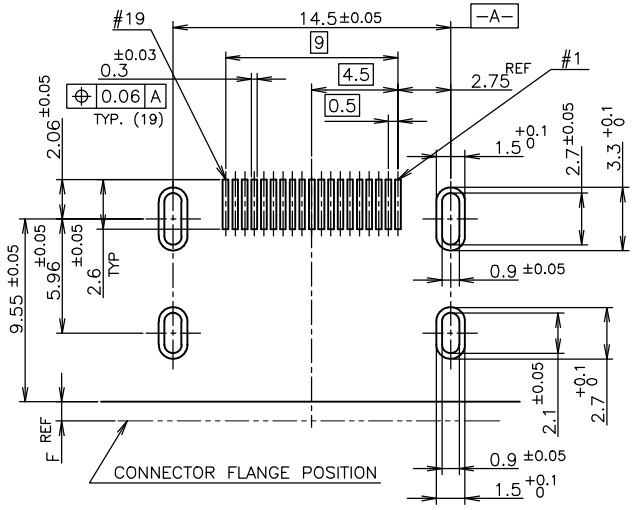

P.C.B LAYOUT
SHOWN AS CONNECTOR MOUNTING SIDE
TOLERANCE: NON–CUMULATIVE
(REFERENCE)

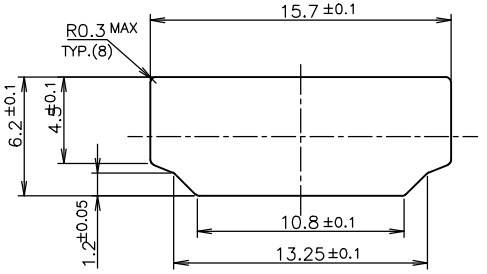

PANEL CUT OUT DIMENSION
(REFERENCE)

NOTICE: THIS COMMUNICATION INCLUDES TE CONNECTIVITY CONFIDENTIAL OR PROPRIETARY INFORMATION THAT MAY ALSO BE LEGALLY PRIVILEGED.

FINISH	MATERIAL	QTY	DISCRIPTION	ITEM
Thickness:0.08mm color: Brown	POLYMIDE	1	POLYIMIDE TAPE	④
③	COPPER ALLOY	19	CONTACT	③
③	COPPER ALLOY	1	SHELL	②
———	THERMOPLASTIC UL94V–0, BLACK COLOR	1	HOUSING	①

THIS DRAWING IS A CONTROLLED DOCUMENT.

DIMENSIONS: mm
TOLERANCES UNLESS OTHERWISE SPECIFIED:
0 PLC ± 0.2
1 PLC ± 0.2
2 PLC ± 0.2
3 PLC ± 0.2
4 PLC ± 0.2
ANGLES ±–
MATERIAL
FINISH

DWN
CHK
APVD
PRODUCT SPEC 108–78180–1
APPLICATION SPEC
WEIGHT
CUSTOMER DRAWING

TE Connectivity

NAME
HDMI 19 POS
RECEPTACLE ASSY SMT TYPE
–LEAD FREE–

SIZE	CAGE CODE	DRAWING NO	RESTRICTED TO
A3	00779	C–1747981	—

SCALE 4:1 SHEET 6 OF 9 REV


1470–19 (3/11)


THIS DRAWING IS UNPUBLISHED. RELEASED FOR PUBLICATION SEP ,2005.
© COPYRIGHT 2005 By – ALL RIGHTS RESERVED.


LOC	DIST
J	—

REVISIONS


P	LTR	DESCRIPTION	DATE	DWN	APVD
	–	SEE SHEET 1	–	—	—

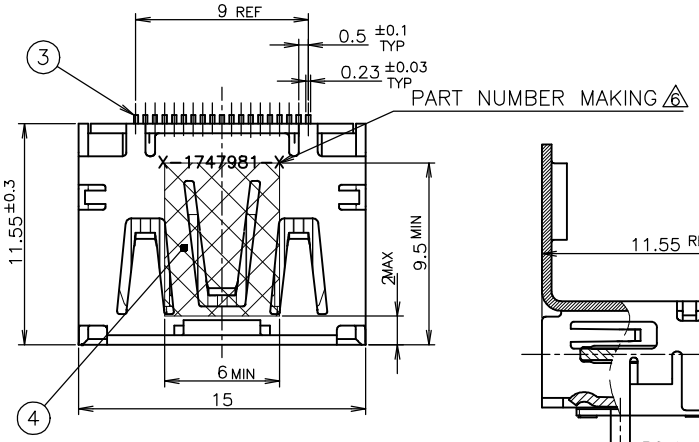


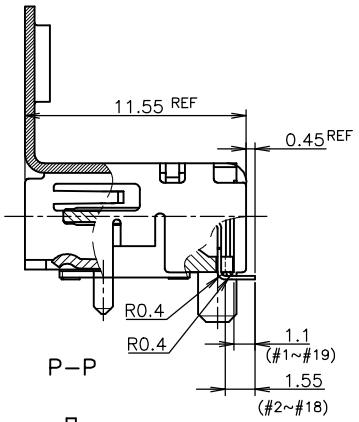

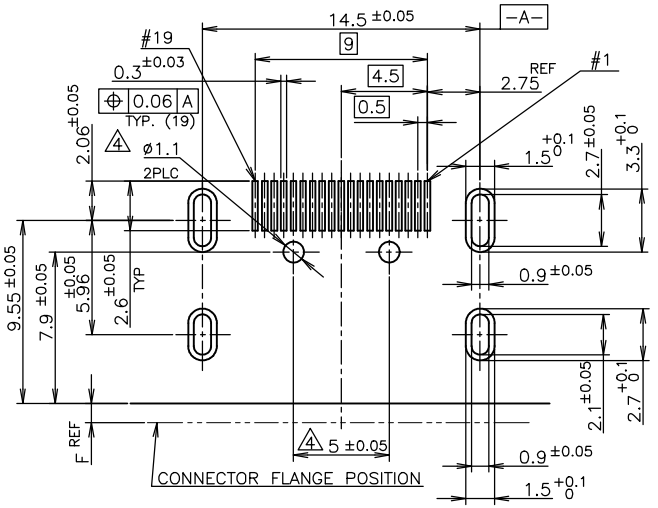


P.C.B LAYOUT
SHOWN AS CONNECTOR MOUNTING SIDE
TOLERANCE: NON–CUMULATIVE
(REFERENCE)

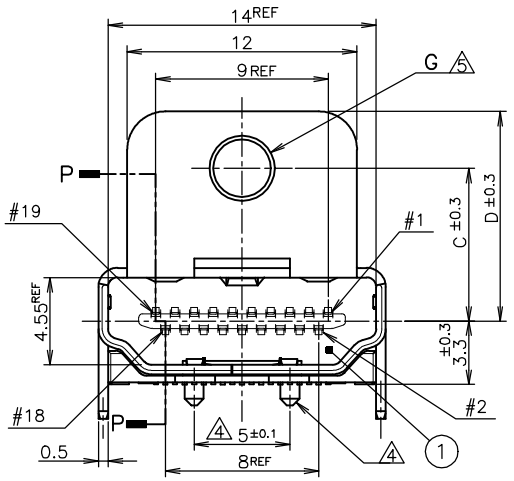

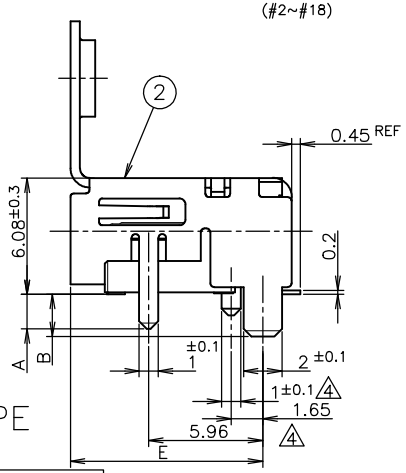

CONNECTOR WITH FLANGE TYPE

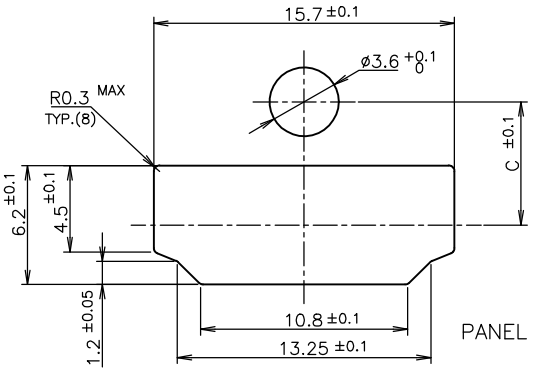

PANEL CUT OUT DIMENSION
(REFERENCE)

NOTICE: THIS COMMUNICATION INCLUDES TE CONNECTIVITY CONFIDENTIAL OR PROPRIETARY INFORMATION THAT MAY ALSO BE LEGALLY PRIVILEGED.

FINISH	MATERIAL	QTY	DISCRIPTION	ITEM
Thickness:0.08 Color: Brown	POLYMIDE	1	POLYIMIDE TAPE	4
3	COPPER ALLOY	19	CONTACT	3
3	COPPER ALLOY	1	SHELL	2
———	THERMOPLASTIC UL94V–0, BLACK COLOR	1	HOUSING	1

THIS DRAWING IS A CONTROLLED DOCUMENT.

DIMENSIONS: mm

TOLERANCES UNLESS OTHERWISE SPECIFIED:

0 PLC	± 0.2
1 PLC	± 0.2
2 PLC	± 0.2
3 PLC	± 0.2
4 PLC	± 0.2
ANGLES	± –

MATERIAL

FINISH

DWN
CHK
APVD
PRODUCT SPEC 108–78180–1
APPLICATION SPEC
WEIGHT
CUSTOMER DRAWING

TE Connectivity

NAME
HDMI 19 POS
RECEPTACLE ASSY SMT TYPE
–LEAD FREE–

SIZE	CAGE CODE	DRAWING NO	RESTRICTED TO
A3	00779	C–1747981	—


SCALE NTS SHEET 7 OF 9 REV

THIS DRAWING IS UNPUBLISHED. RELEASED FOR PUBLICATION SEP ,2005.
© COPYRIGHT 2005 By – ALL RIGHTS RESERVED.


LOC	DIST
J	—

REVISIONS


P	LTR	DESCRIPTION	DATE	DWN	APVD
	–	SEE SHEET 1	–	—	—

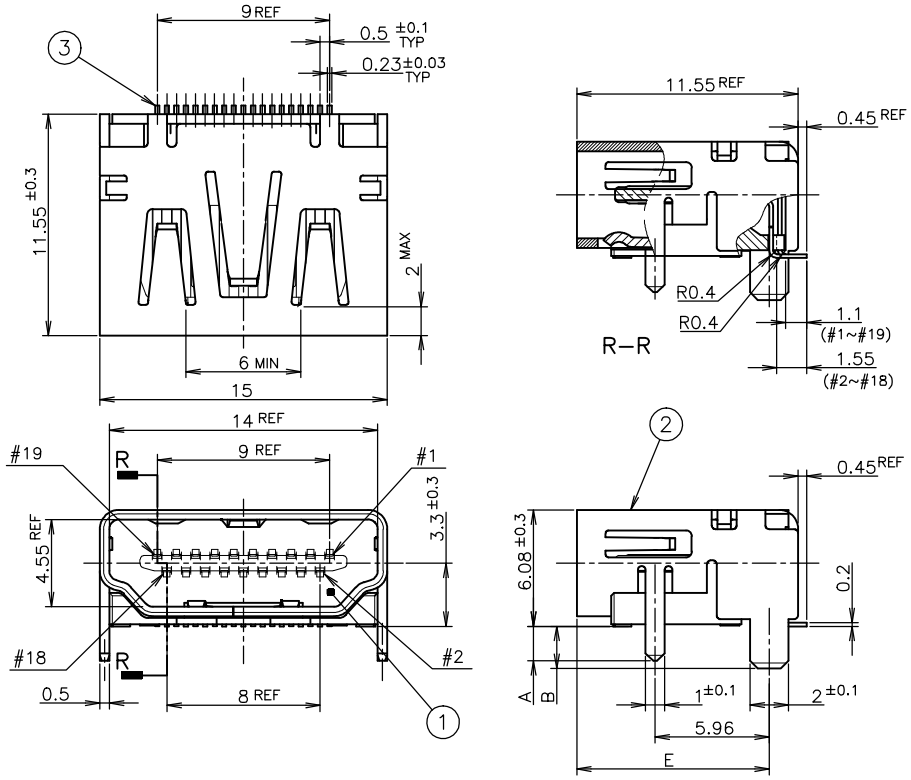

CONNECTOR WITHOUT FLANGE TYPE

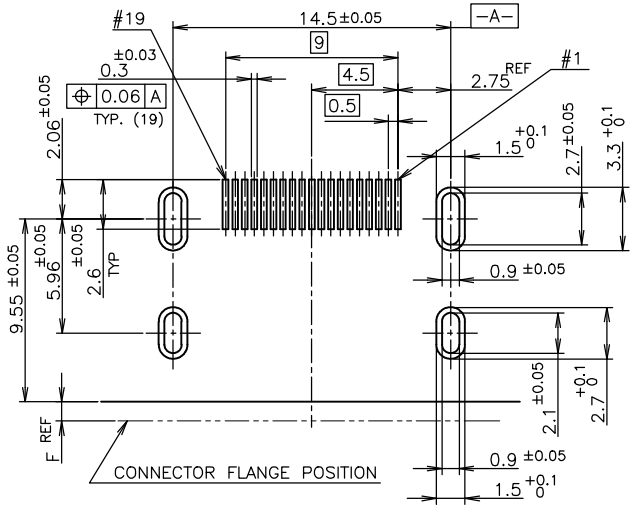

P.C.B LAYOUT
SHOWN AS CONNECTOR MOUNTING SIDE
TOLERANCE: NON–CUMULATIVE
(REFERENCE)

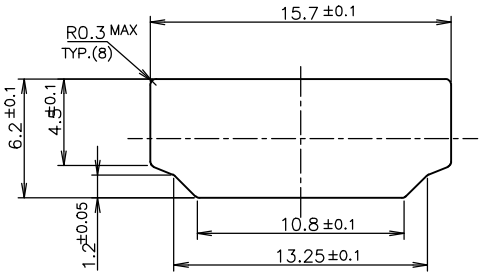

PANEL CUT OUT DIMENSION
(REFERENCE)

NOTICE: THIS COMMUNICATION INCLUDES TE CONNECTIVITY CONFIDENTIAL OR PROPRIETARY INFORMATION THAT MAY ALSO BE LEGALLY PRIVILEGED.

FINISH	MATERIAL	QTY	DISCRIPTION	ITEM
③	COPPER ALLOY	19	CONTACT	③
③	COPPER ALLOY	1	SHELL	②
—	THERMOPLASTIC UL94V–0, BLACK COLOR	1	HOUSING	①

THIS DRAWING IS A CONTROLLED DOCUMENT.

DIMENSIONS: mm
TOLERANCES UNLESS OTHERWISE SPECIFIED:
0 PLC ± 0.2
1 PLC ± 0.2
2 PLC ± 0.2
3 PLC ± 0.2
4 PLC ± 0.2
ANGLES ±–
MATERIAL
FINISH

DWN
CHK
APVD
PRODUCT SPEC 108–78180–1
APPLICATION SPEC
WEIGHT
CUSTOMER DRAWING

TE Connectivity

NAME
HDMI 19 POS
RECEPTACLE ASSY SMT TYPE
–LEAD FREE–

SIZE	CAGE CODE	DRAWING NO	RESTRICTED TO
A3	00779	C–1747981	—

SCALE	SHEET	REV
4:1	8 OF 9	


THIS DRAWING IS UNPUBLISHED. RELEASED FOR PUBLICATION SEP ,2005.
© COPYRIGHT 2005 By – ALL RIGHTS RESERVED.

LOC	DIST
J	—


REVISIONS

P	LTR	DESCRIPTION	DATE	DWN	APVD
	–	SEE SHEET 1	–	—	—

NOTICE: THIS COMMUNICATION INCLUDES TE CONNECTIVITY CONFIDENTIAL OR PROPRIETARY INFORMATION THAT MAY ALSO BE LEGALLY PRIVILEGED.

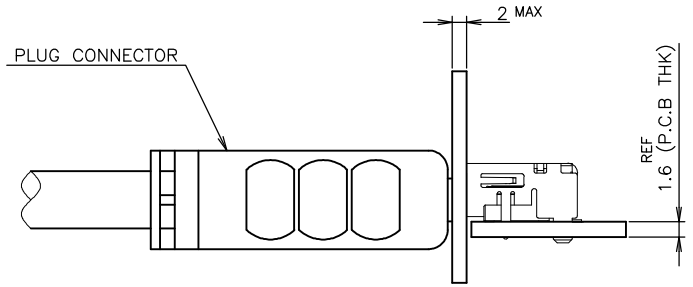

CONNECTOR WITHOUT FLANGE TYPE

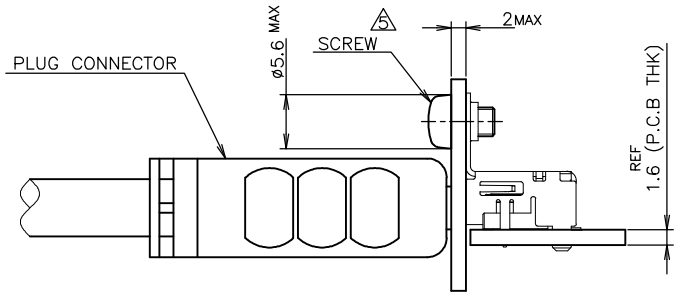

CONNECTOR WITH FLANGE TYPE

MATING CONDITION (REFERENCE)
(SCALE 2:1)

THIS DRAWING IS A CONTROLLED DOCUMENT.

DIMENSIONS: mm

TOLERANCES UNLESS OTHERWISE SPECIFIED:

0 PLC	± 0.2
1 PLC	± 0.2
2 PLC	± 0.2
3 PLC	± 0.2
4 PLC	± 0.2
ANGLES	± –

MATERIAL

FINISH

DWN

CHK

APVD

PRODUCT SPEC 108-78180-1

APPLICATION SPEC

WEIGHT

CUSTOMER DRAWING

TE Connectivity

NAME HDMI 19 POS RECEPTACLE ASSY SMT TYPE -LEAD FREE-

SIZE	CAGE CODE	DRAWING NO	RESTRICTED TO
A3	00779	C-1747981	—

SCALE	SHEET	REV
2:1	9 OF 9	

1470-19 (3/11)

Unikeyic Electronics

Global Electronic Components Distributor

Click to view pricing, inventory, delivery, and lifecycle information:

TE Connectivity:

1-962915-1 2377783-2 TE50BR39J RH73H2A40MKTN SBCHE64R7K SMW73R0JT 1743455-2 917696-1 CRGCQ2010J3K3 175977-2 3430B2F51RTDF CPF0402B37K4E1 U5254-000005-030PA 1-794222-0 1393431-1 3631B101LL ROX05SJ18R 2-292161-3 2310537-1 936348-1 SBCHE154R7K MPT100C18RF 141991-2 1903112-2 1969656-1 2834055-1 650075-000 2380312-2 2005330-1 3-1393225-0